


SOMERVILLE
MIDDLESEX COUNTY
MASSACHUSETTS



NOTICE TO UTILITY LOCATORS:
All TOWARDEX owned underground facilities, including ducts and cable vaults shall be delineated and marked on surface with identifying abbreviation of "TWDX"

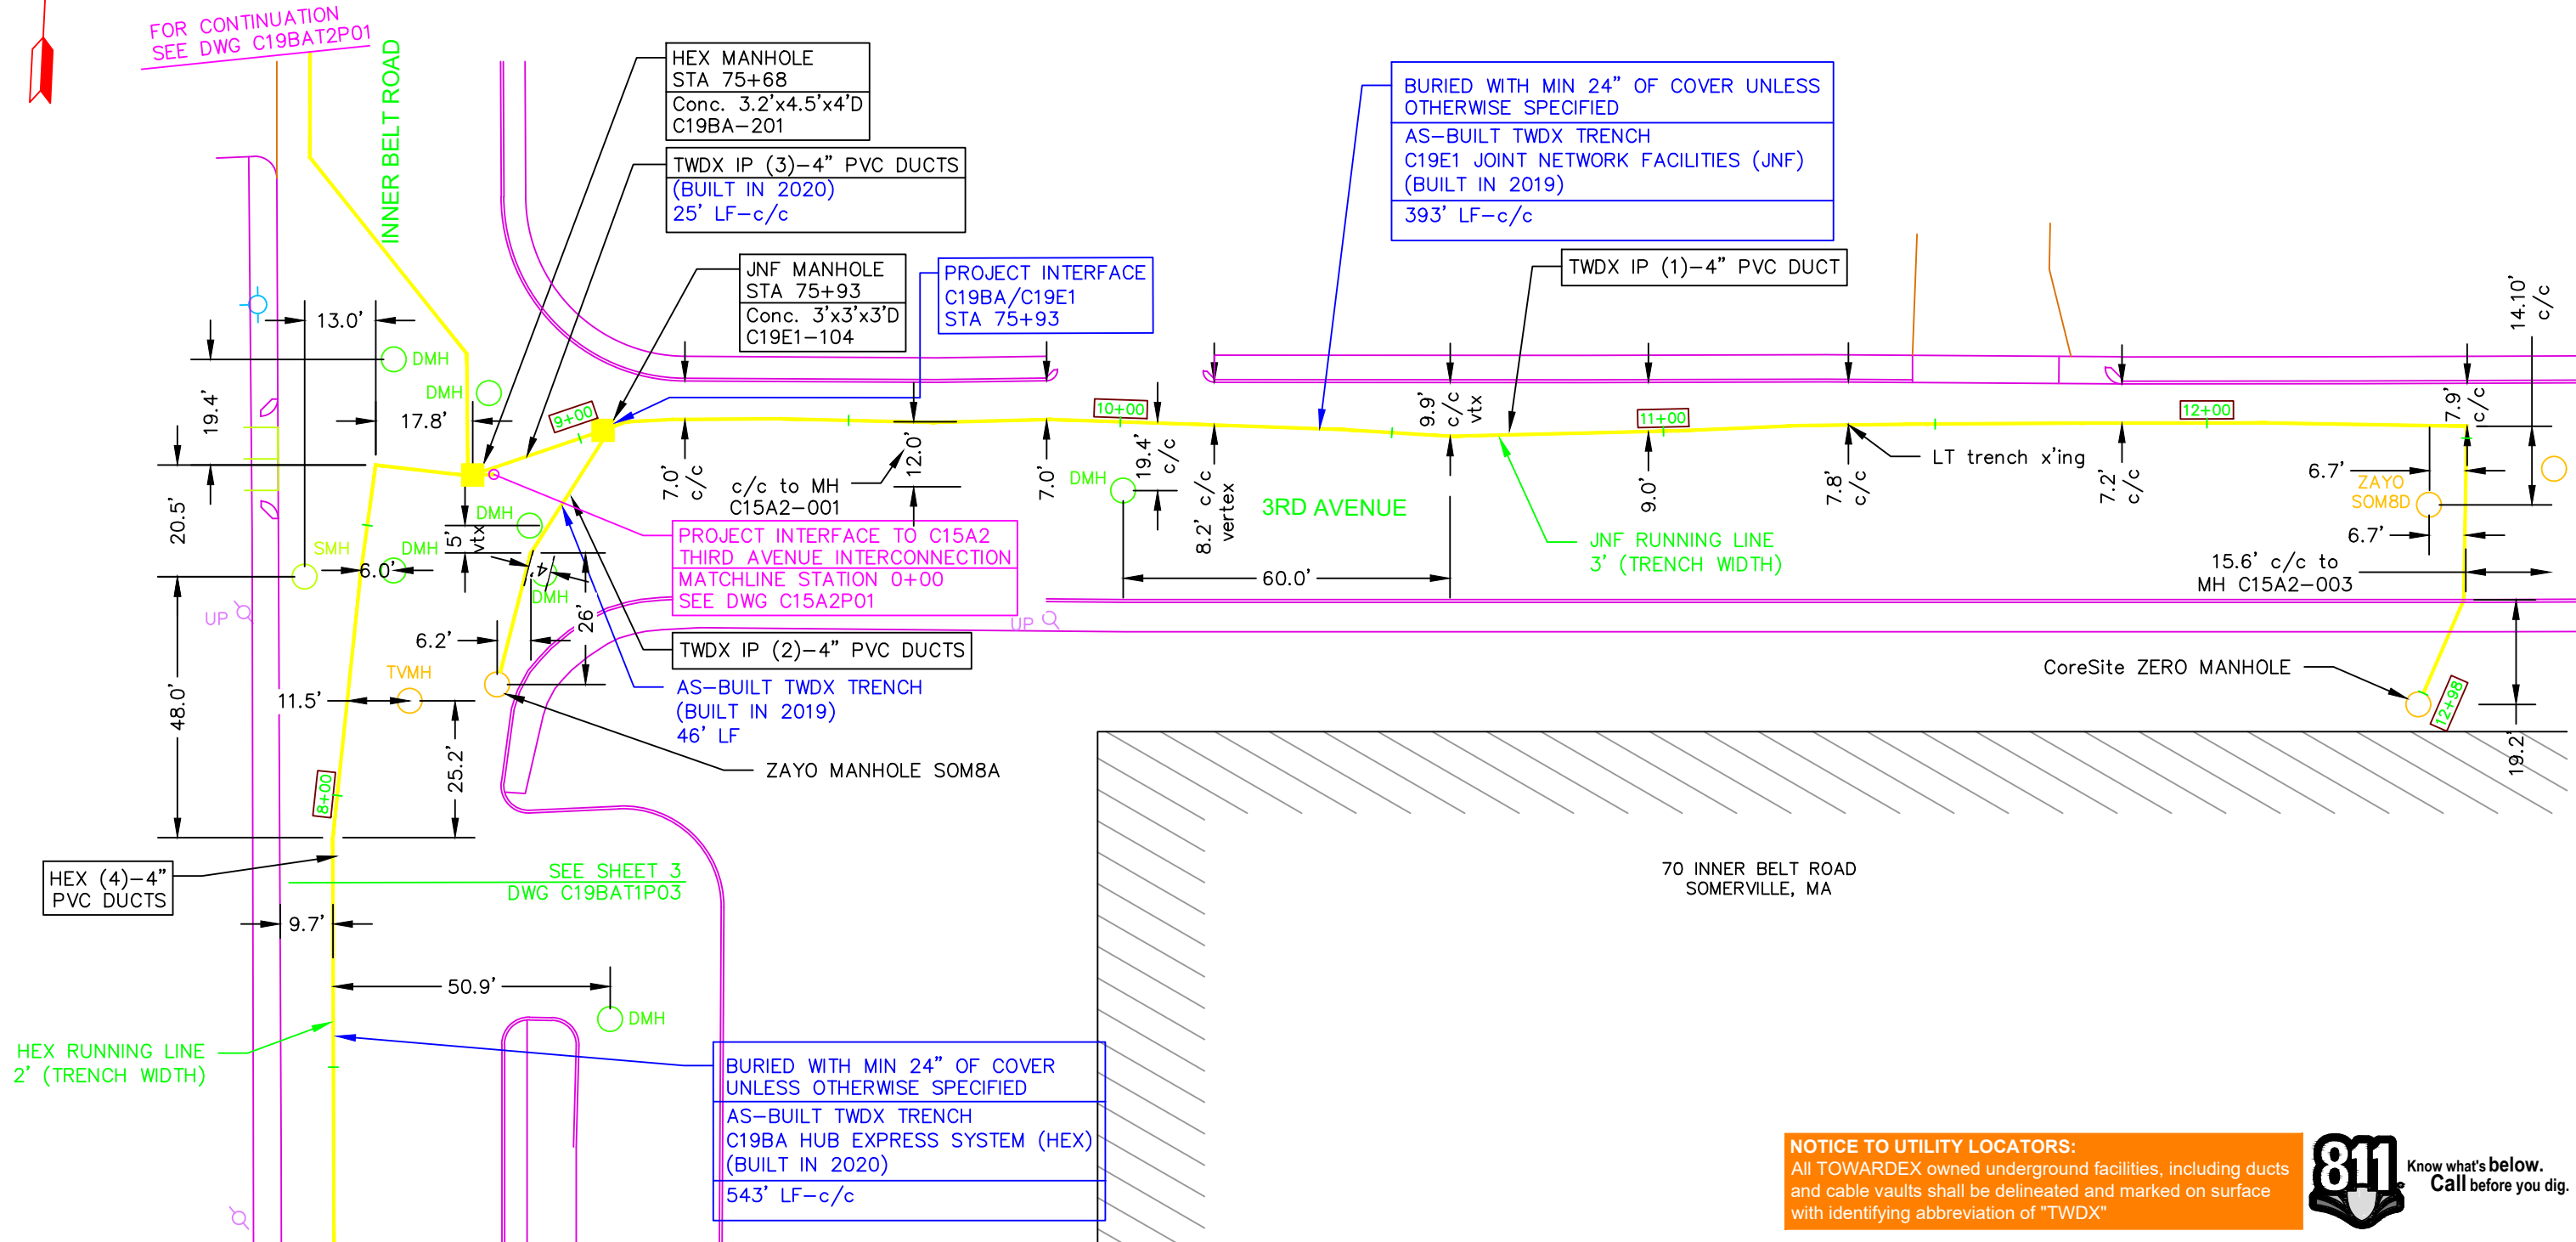

Y:\IP Planning\HubExpress (HEX) Program\As Built System Diagrams\C19BAT1\C19BAT1P99.dwg
Nov 04,2022 - 4:59pm by gkeyes

Designed by J. CONNOR
Checked by J. KENNEDY
Date 2/3/2021

CONDUIT RECORD PLAN



PREPARED BY:

50 Mall Road, Suite 203, Burlington, MA 01803
p 781.221.8400 f 781.221.7117

PREPARED FOR:

Your network success story.

PROJECT TITLE:
AS-BUILT CONDUIT PLACEMENT PLAN
70 INNER BELT ROAD
SOMERVILLE, MA 02143

SHEET NUMBER:
4
OF 4 SHEETS